

C.M. ENGINEERING ASSOCIATES
 Civil Engineering, Planning & Surveying
 234 No. Arrowhead Avenue
 San Bernardino, California 92408
 Phone: (714) 884-8804

Approved By: *Don B. Miller* Date: 10/22/69
 R.C.E. 3750

H.O. 5-69-6 For Malton Construction Co.

MARK	REVISIONS	APPR. DATE

DESIGNED BY R.L.V. DRAWN BY J.B. CHECKED BY D.B.M.

Approved By: *Howard K. Ormerod* 12-10-69
 Chief, Public Utilities Engineer - Water Date

CITY OF RIVERSIDE, CALIFORNIA
 DEPARTMENT OF PUBLIC WORKS

APPROVED BY: *[Signature]*
 OFFICE ENGINEER
 PARK DEPARTMENT
 TRAFFIC DIVISION
 ASSISTANT CITY ENGINEER



DATE: 1-5-70

SEWER PLAN AND PROFILE

ALLEY "B"
TRACT NO. 3960

HORIZ. SCALE: 1" = 40' VERT. SCALE: 1" = 4'

PROJECT NO. **5-779**
 SHEET **2** OF **4**
 FILE NO.

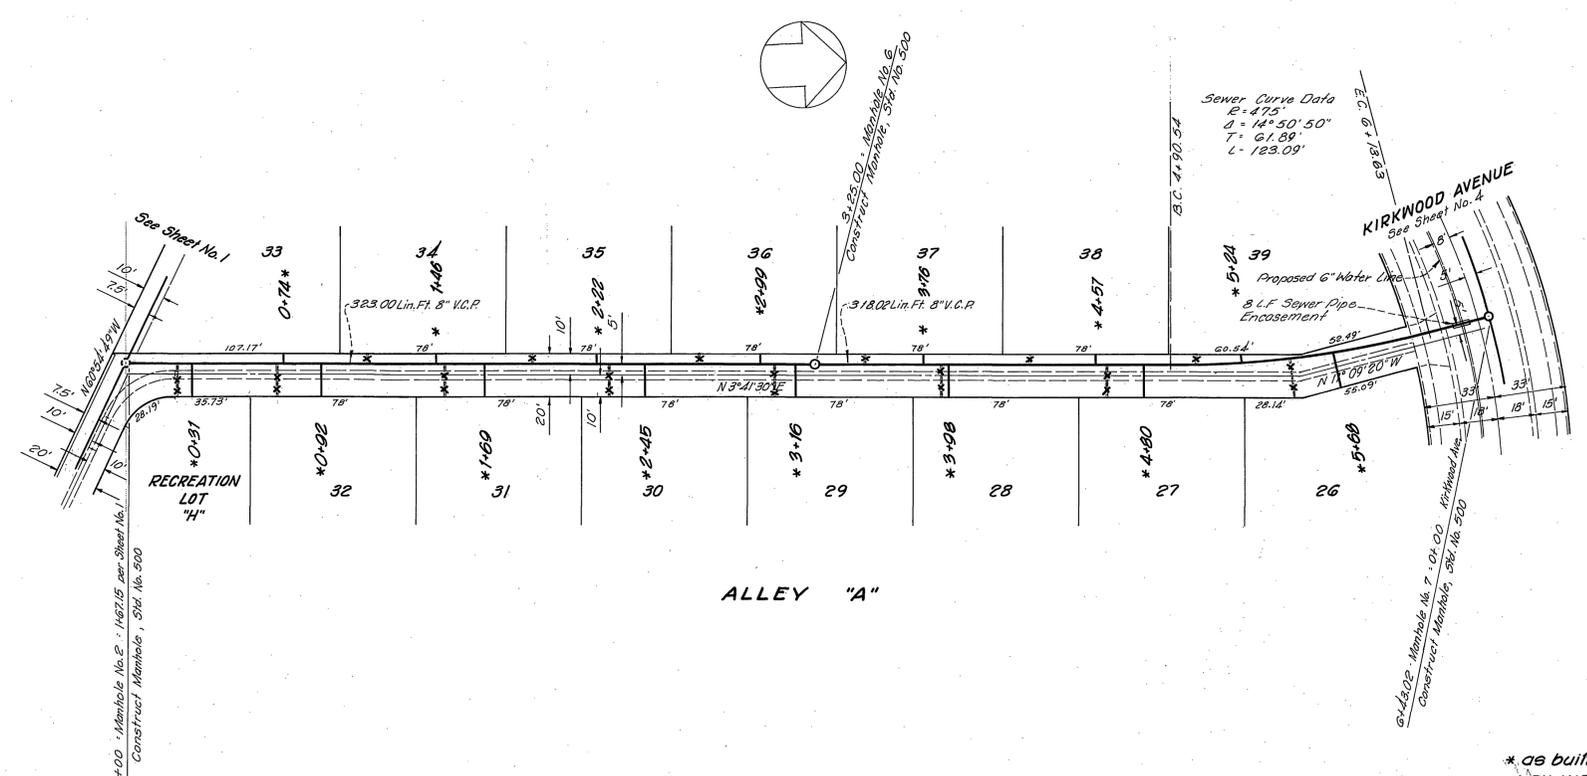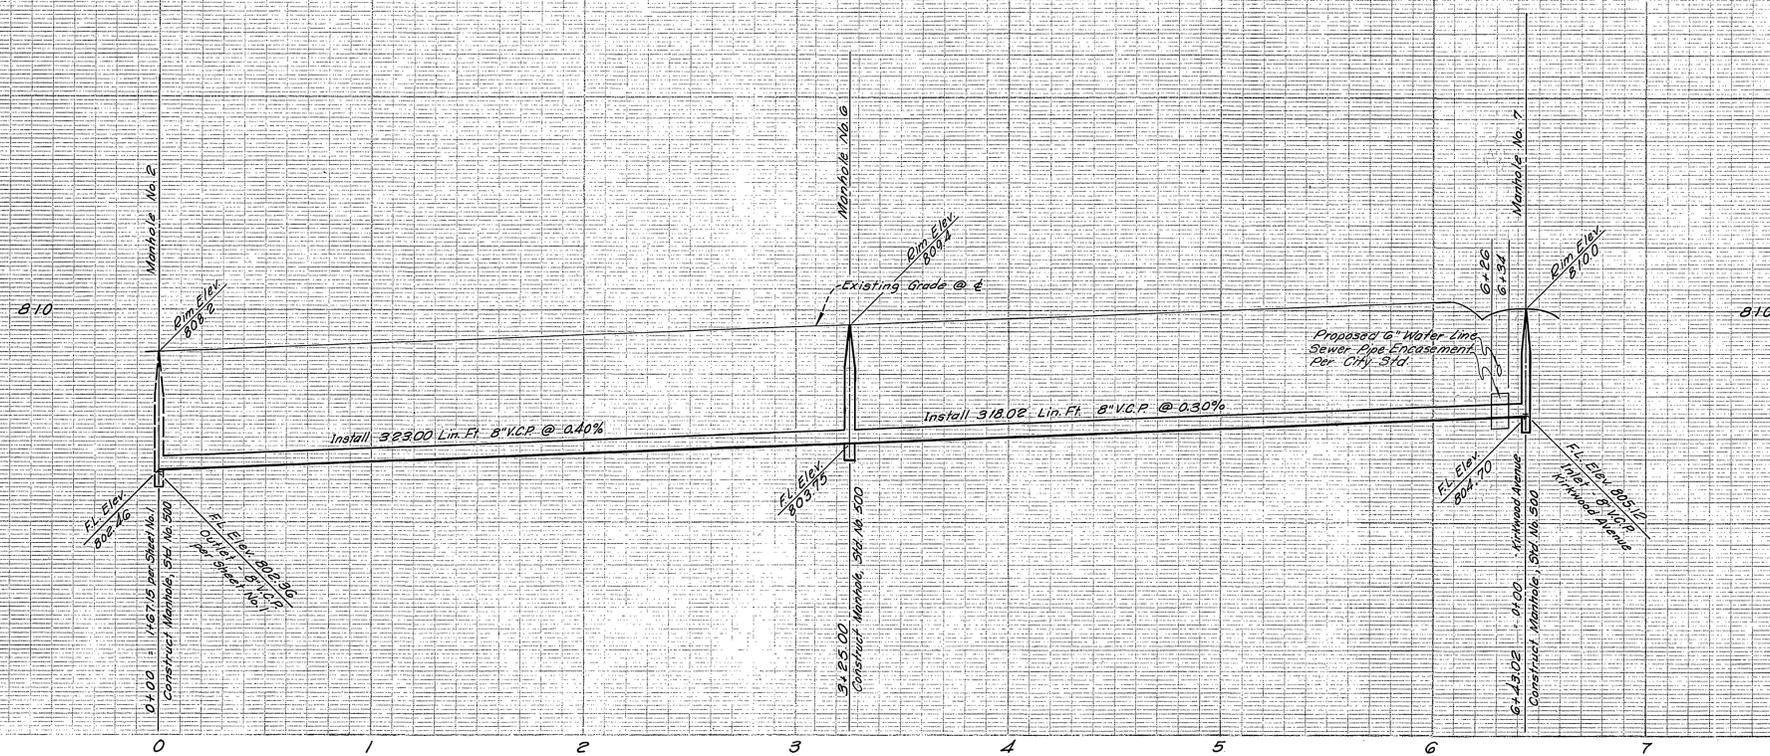

* 26 built 5-1-70 norm
 ✓ BY KARL

C.M. ENGINEERING ASSOCIATES
 Civil Engineering, Planning & Surveying
 234 No. Arrowhead Avenue
 San Bernardino, California 92408
 Phone: (714) 884-8804

Approved By: *Don B. Miller* Date: 10/22/69
 R.C.E. 3750
 W.D. 5-69-6 For McKean Construction Co.

MARK REVISIONS APPR. DATE
 DESIGNED BY R.L.V. DRAWN BY J.B. CHECKED BY D.D.M.

Approved By: *Howard A. Craven* 12-10-69
 Chief Public Utilities Engineer - Water Date

CITY OF RIVERSIDE, CALIFORNIA
DEPARTMENT OF PUBLIC WORKS



APPROVED BY	BY	DATE	APPROVED BY
OFFICE ENGINEER	<i>[Signature]</i>	12/31	<i>[Signature]</i>
PARK DEPARTMENT			DIRECTOR OF PUBLIC WORKS
TRAFFIC DIVISION			
ASSISTANT CITY ENG.			

SEWER PLAN AND PROFILE PROJECT NO.

ALLEY "A" PROJECT NO. **5-779**

TRACT NO. 3960 SHEET 3 OF 4

HORIZ. SCALE: 1" = 40' VERT. SCALE: 1" = 4' FILE NO.

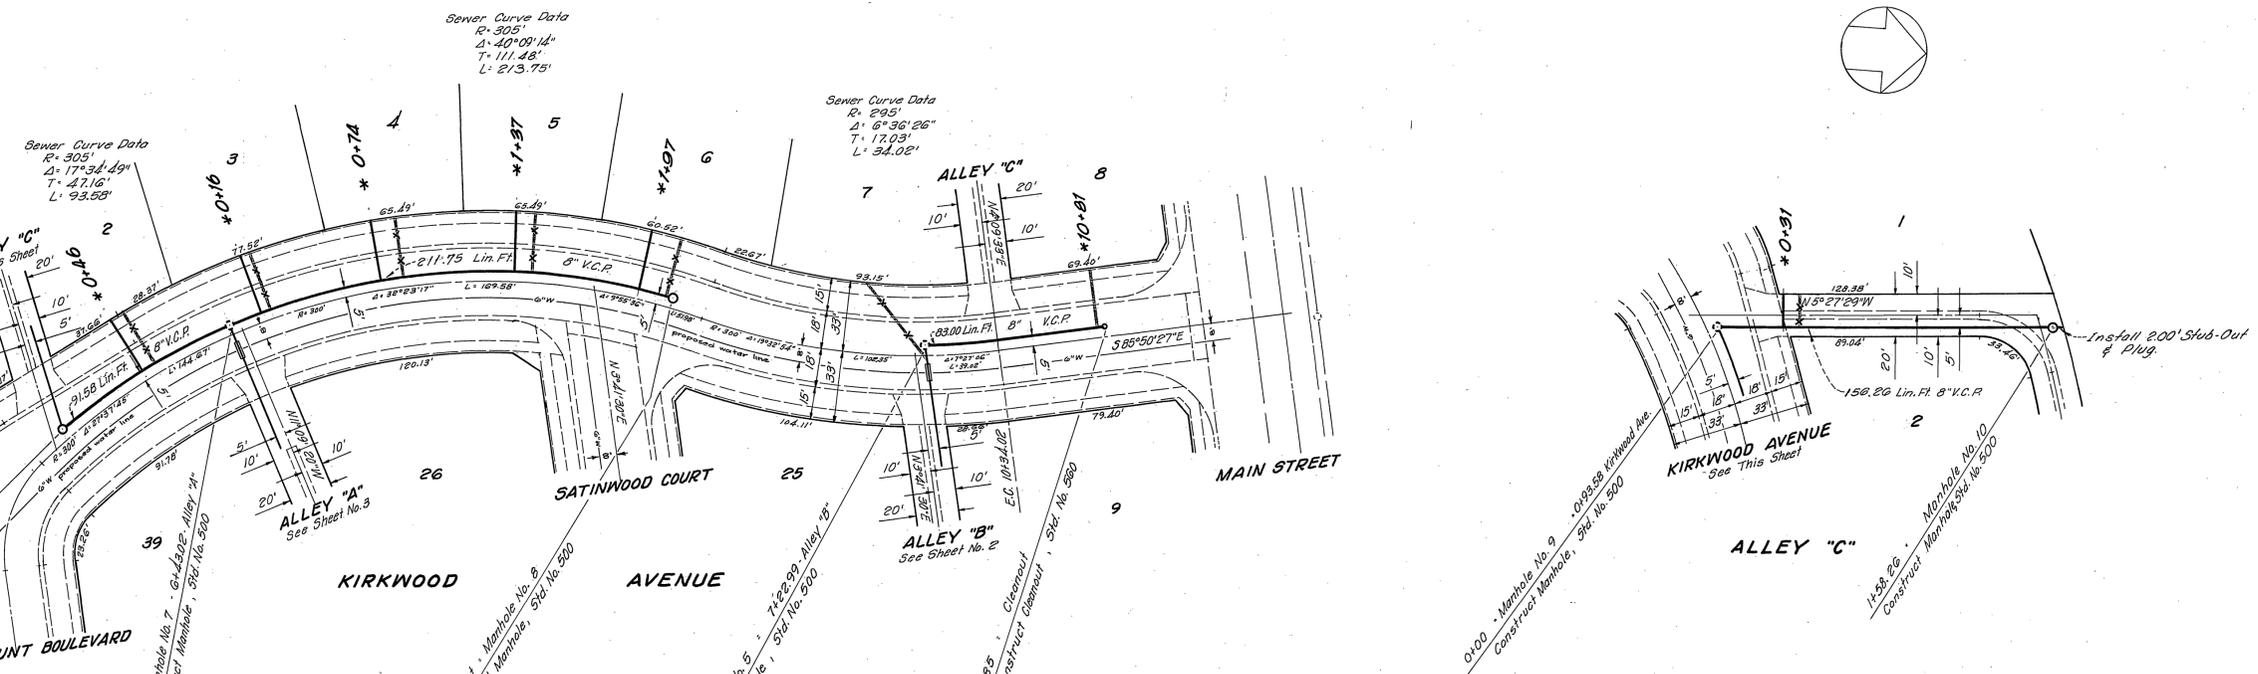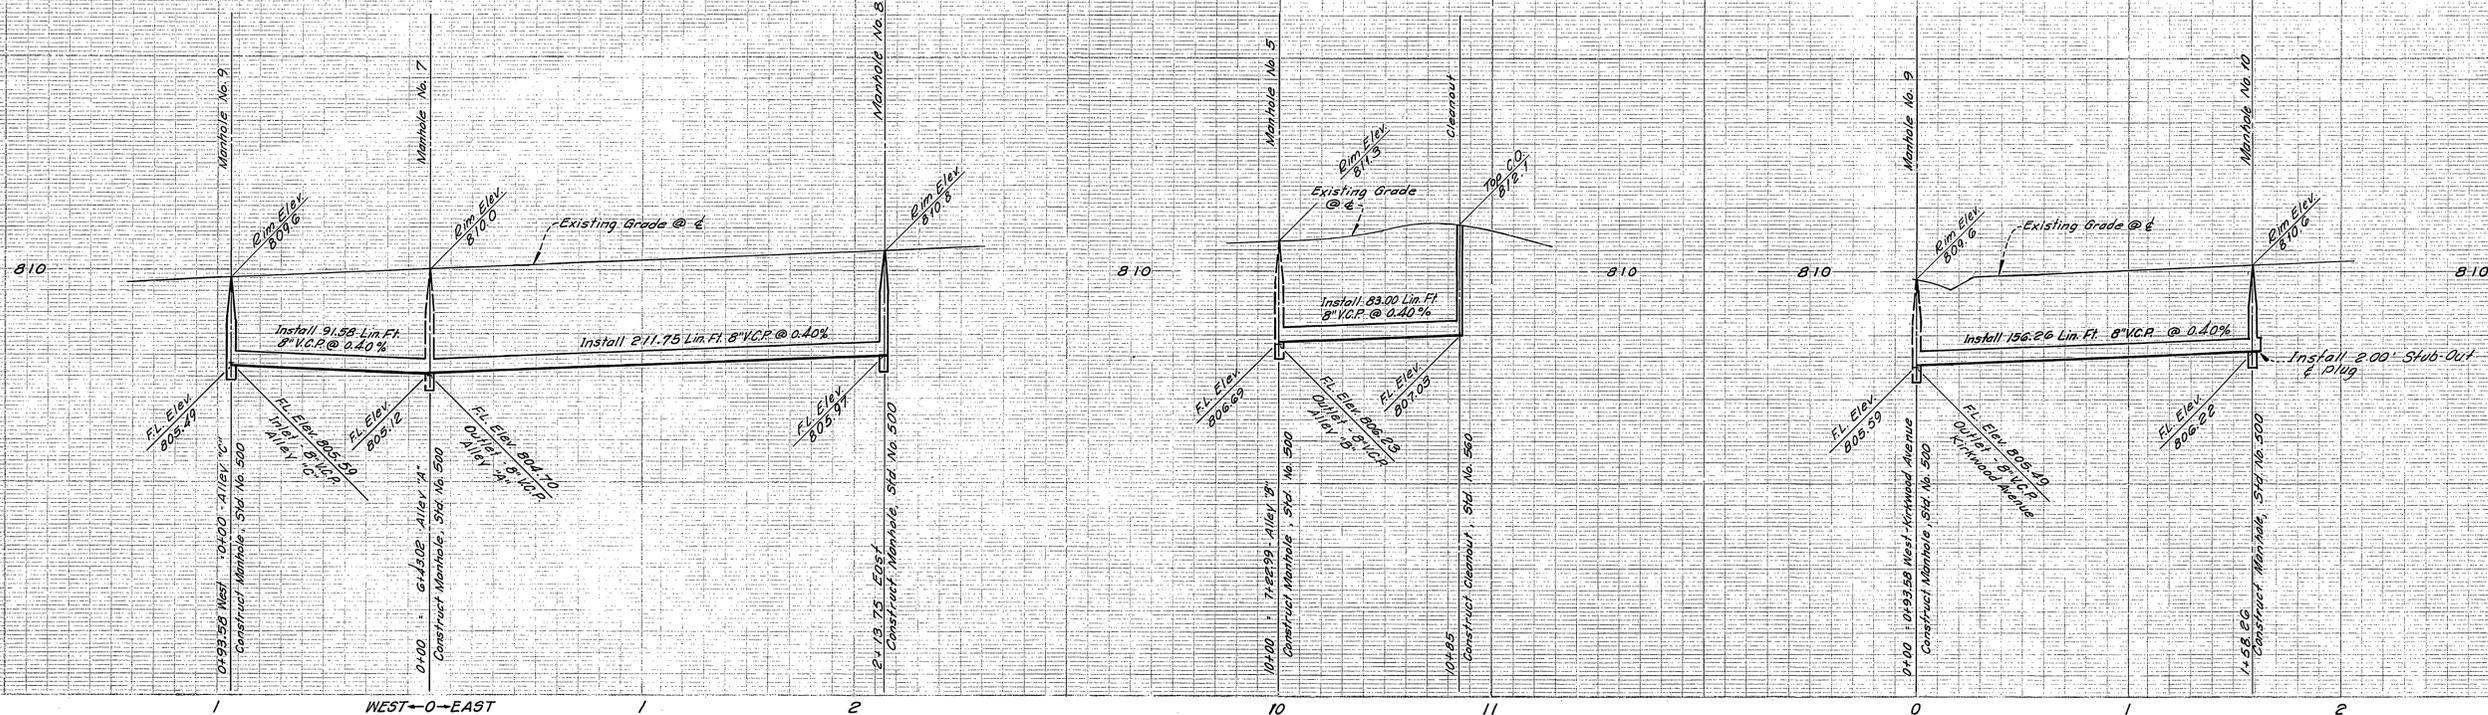

0+99.58 West Manhole No. 9 0+100 Alley "C"
Construct Manhole, Std. No. 500

0+00 Manhole No. 7 0+43.02 Alley "A"
Construct Manhole, Std. No. 500

21+3.75 East Manhole No. 8
Construct Manhole, Std. No. 500

10+00 Manhole No. 5 1+22.99 Alley "B"
Construct Manhole, Std. No. 500

0+00 Manhole No. 9 0+99.58 Kirkwood Ave.
Construct Manhole, Std. No. 500

1+58.26 Manhole No. 10
Construct Manhole, Std. No. 500

* as built 5-1-70 norm
✓ BY KARL

C.M. ENGINEERING ASSOCIATES
Civil Engineering, Planning & Surveying
234 No. Arrowhead Avenue
San Bernardino, California 92408
Phone: (714) 841-8804
Approved By: *Don C. Miller* date 10/22/69
R.C.E. 0750
W.O. 5-69-G For McKeon Construction Co.

Approved By:
Howard J. Orman 12-10-69
Chief Public Utilities Engineer - Water
CITY OF RIVERSIDE, CALIFORNIA
DEPARTMENT OF PUBLIC WORKS
APPROVED BY: *[Signature]* DATE: 1-5-70
OFFICE ENGINEER: *[Signature]* DATE: 12/21
TRAFFIC DIVISION: *[Signature]*
ASSISTANT CITY ENGINEER: *[Signature]*

SEWER PLAN AND PROFILE
KIRKWOOD AVENUE
ALLEY "C"
TRACT NO. 3960
PROJECT NO. **5-779**
SHEET 4 OF 4
HORIZ. SCALE: 1" = 40'
VERT. SCALE: 1" = 4'
FILE NO.